


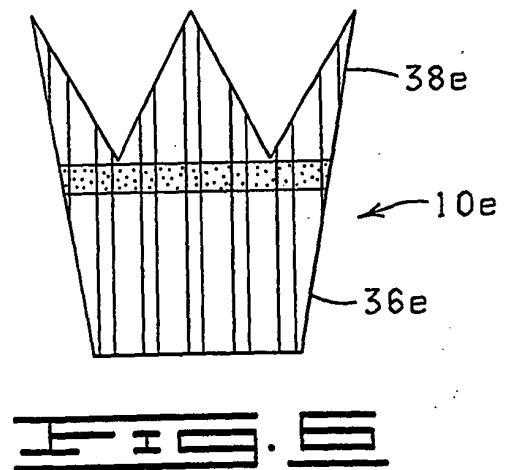
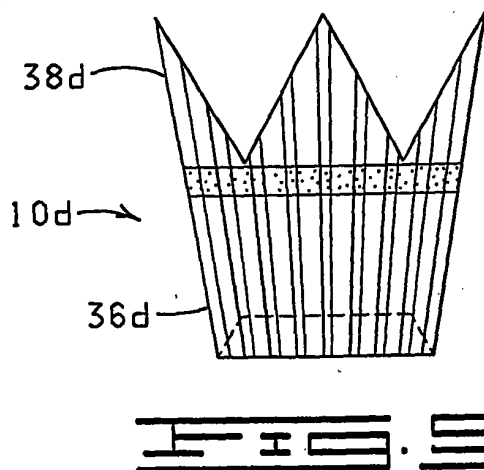
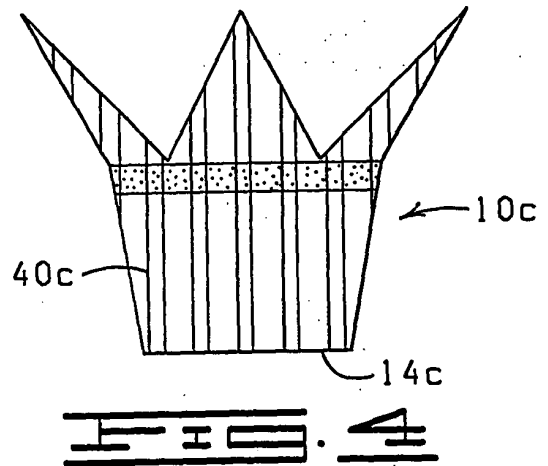
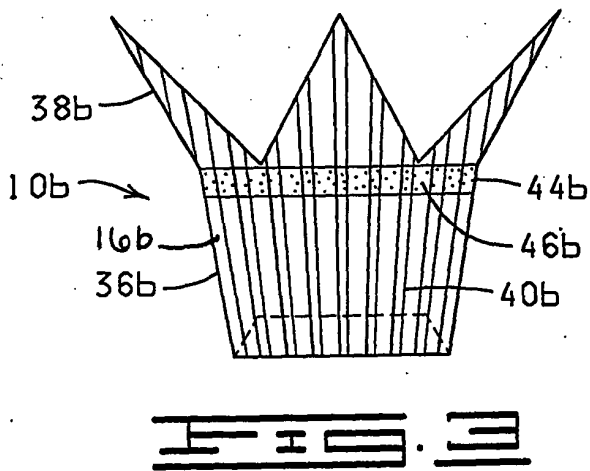
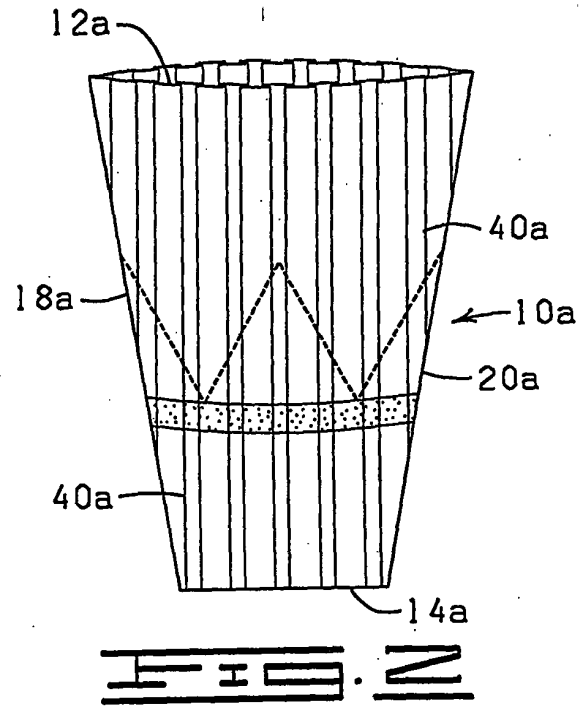
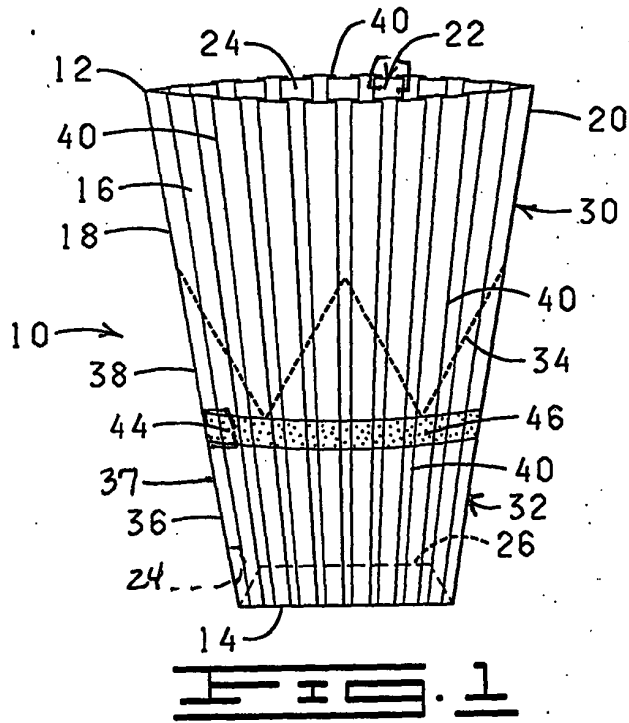
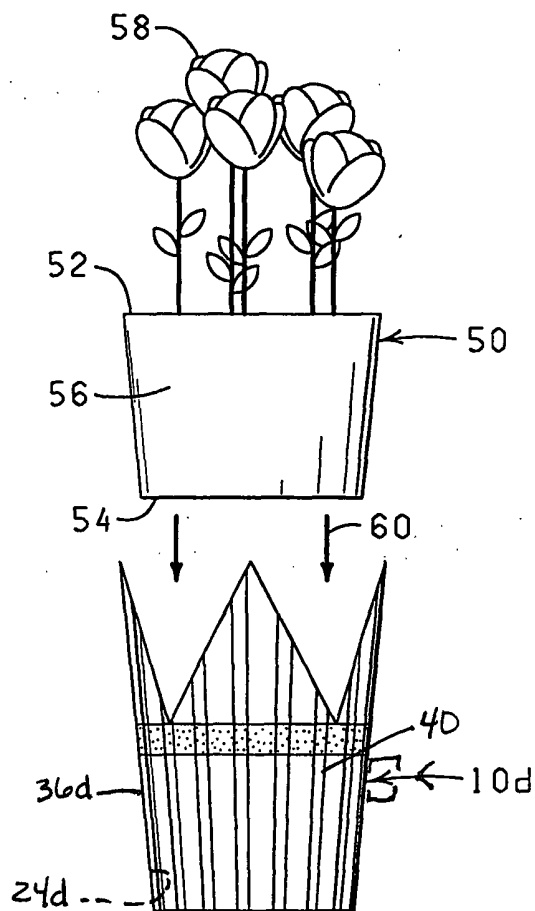
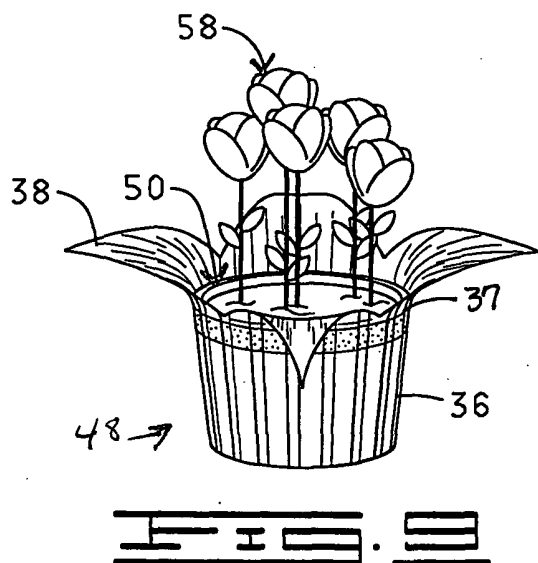



Redline Version of  
 Drawings: Not for  
 Publication

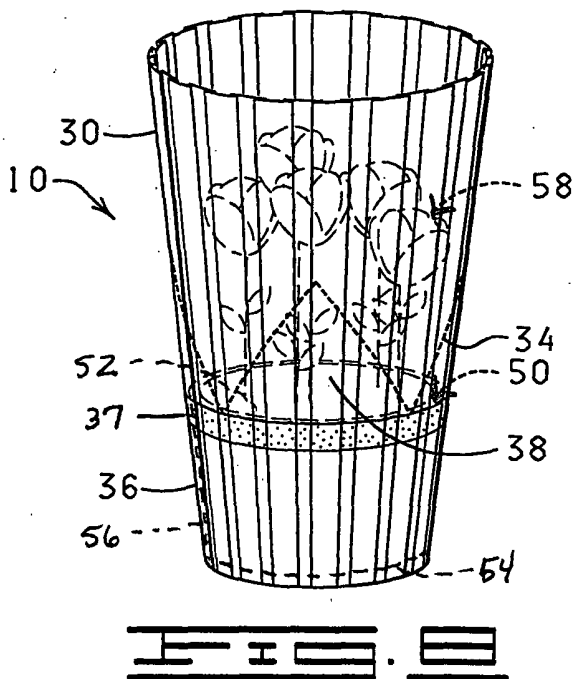

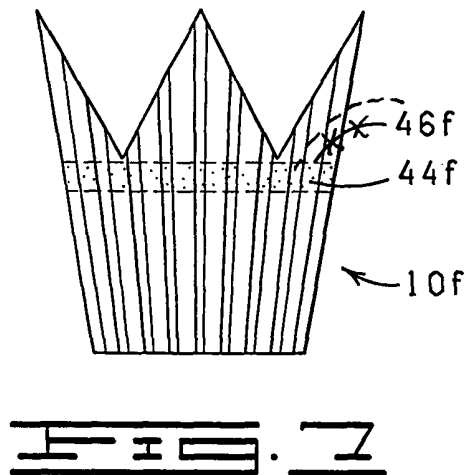


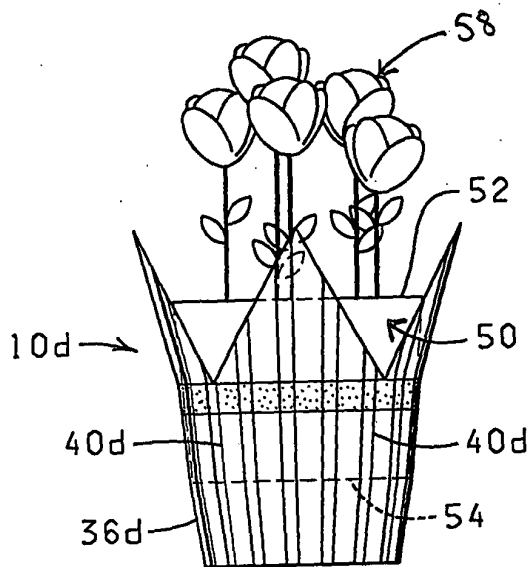


**FIG. 11**

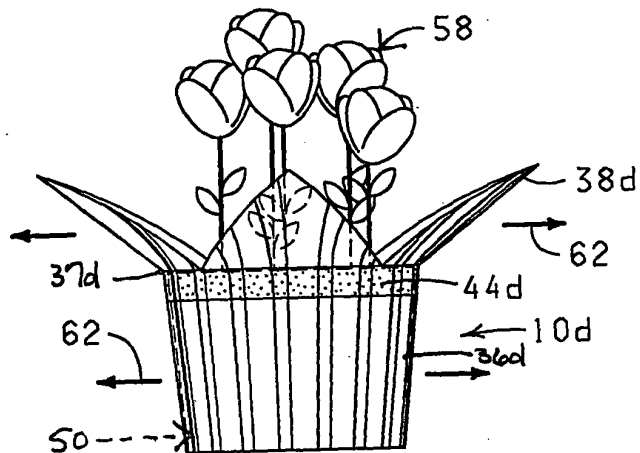


**FIG. 12**

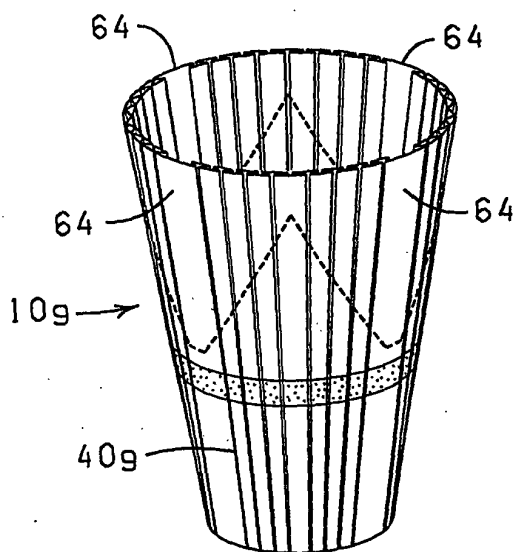


**FIG. 13**

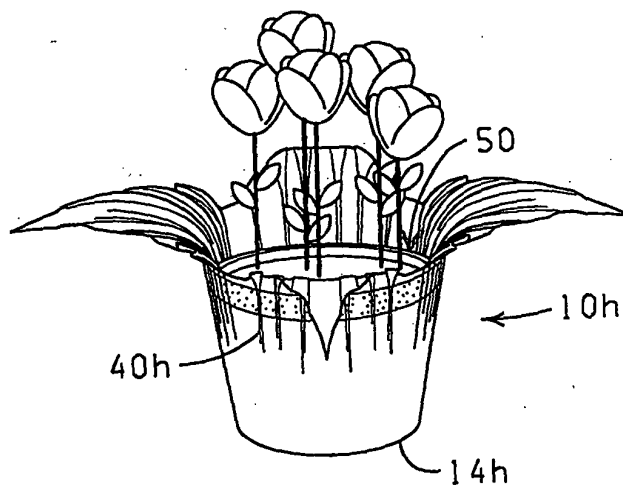


**FIG. 14**

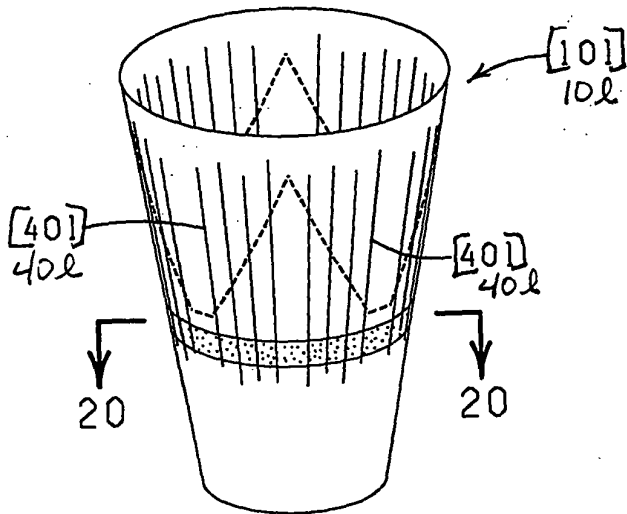


**FIG. 19**

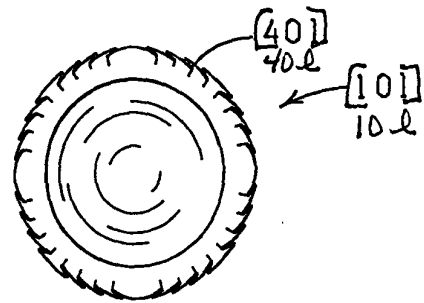

**FIG. 20**

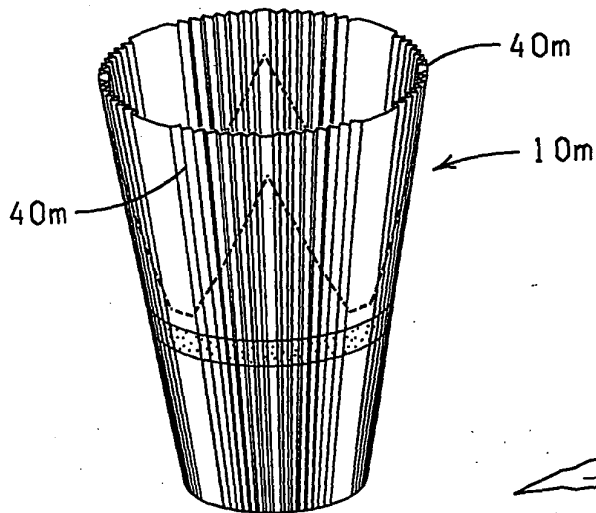

**FIG. 21**

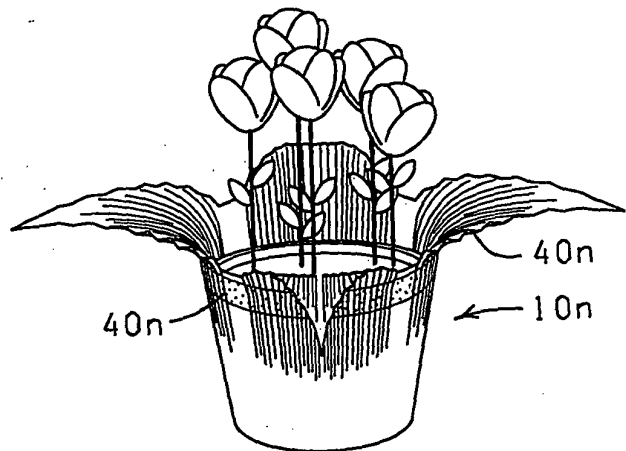

**FIG. 22**